


CCTV required in lift

Polycarbonate roof panels to be removed so area is not used in inclement weather

door alarmed and access restricted to escape during fire only

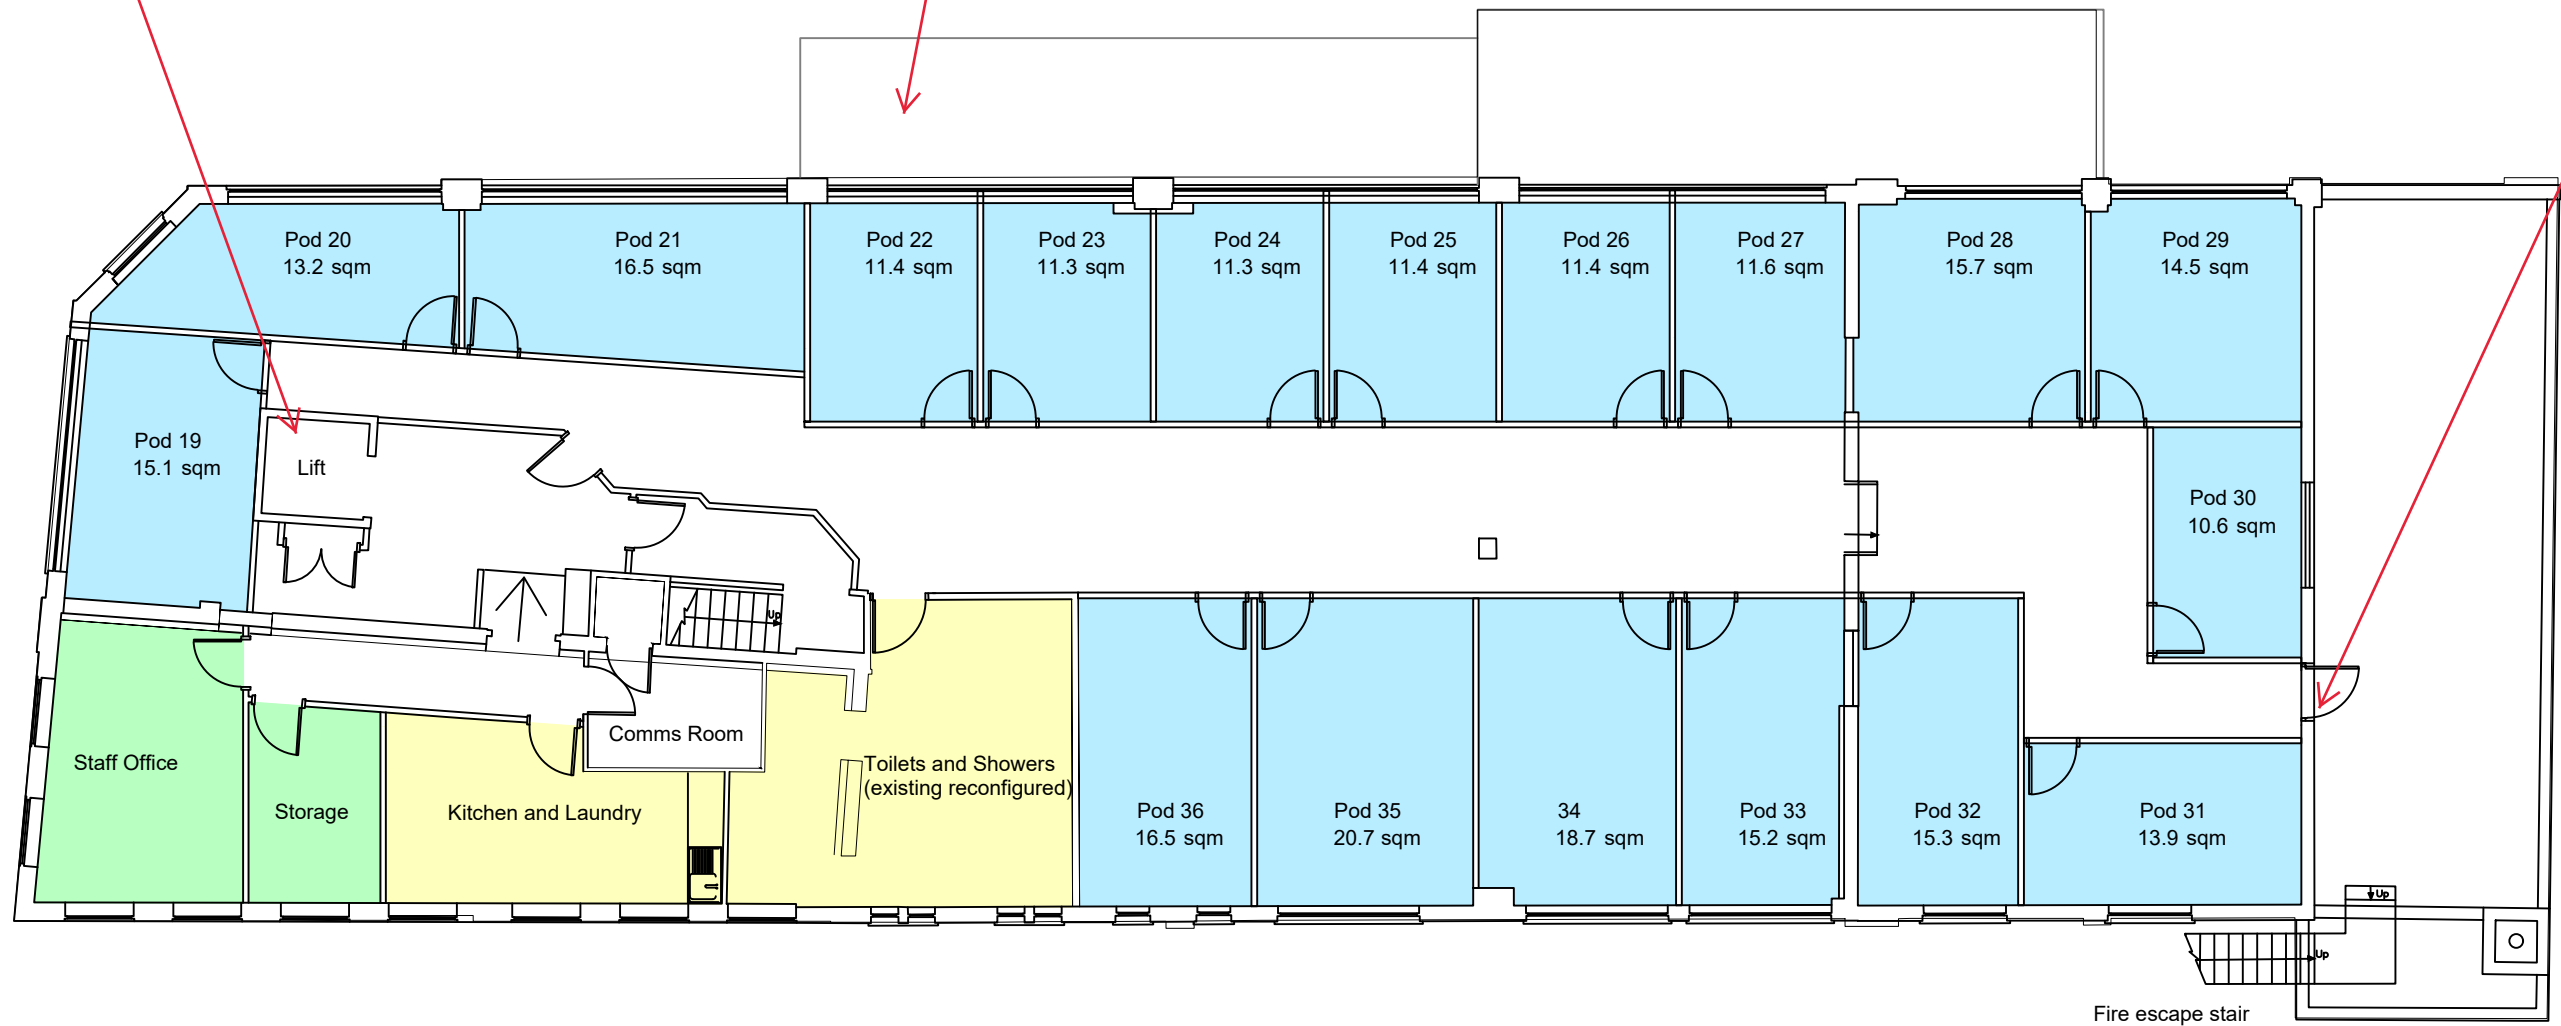

John Wilkes House  
Drawing A201  
Proposed First Floor  
Scale 1:150 @ A3  
Revision A  
Issued 22.03.2024  
Issued for Planning  
Drawn by Enfield Council Architecture Team

